


8 7 6 5 4 3 2 1


REVISIONS				
ZONE	REV	DESCRIPTION	DATE	APPROVED

NOTES:


- 1) FUEL TANK AS INSTALLED ON 61/FF/108.
- 2) BELIEVED TO BE ORIGINAL TANK.
- 3) TOP, AND FRONT ONE CONTINUOUS PIECE OF ALUMINUM. BOTTOM AND SIDES (2) ONE CONTINUOUS PIECE OF ALUMINUM.
- 4) APPEARS TO HAVE BEEN GAS WELDED.
- 5) ALUMINUM THICKNESS .065"
- 6) TANK CAPACITY ?? GALLON US, APPROX. WITH OUT FUEL BLATTER INSTALLED.

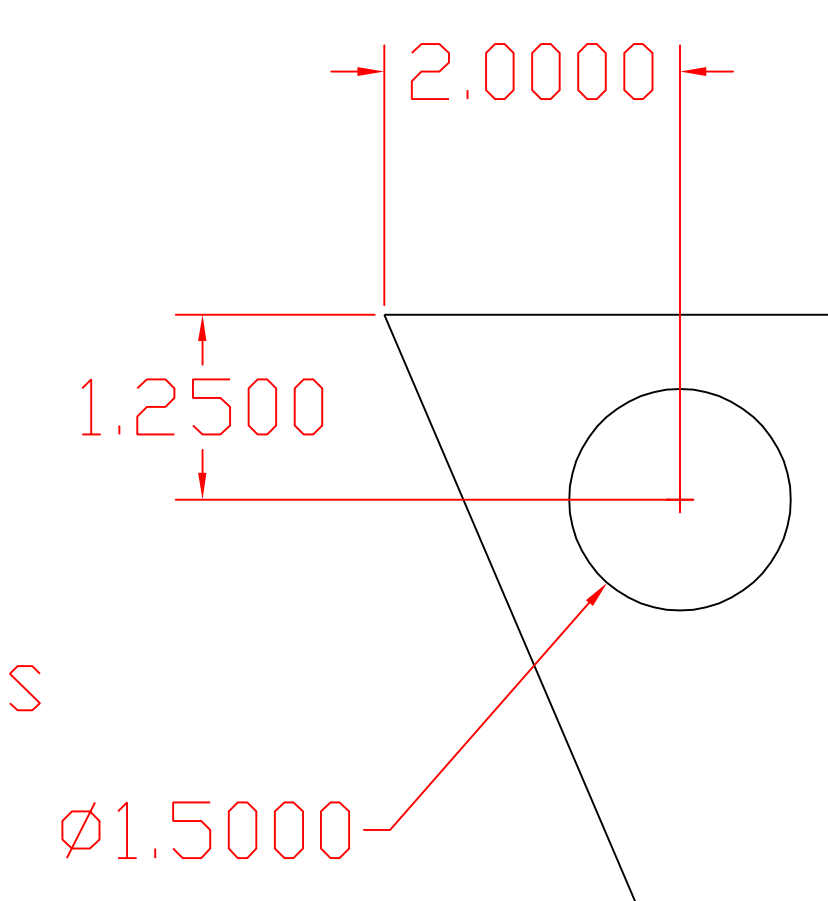

TOP VIEW

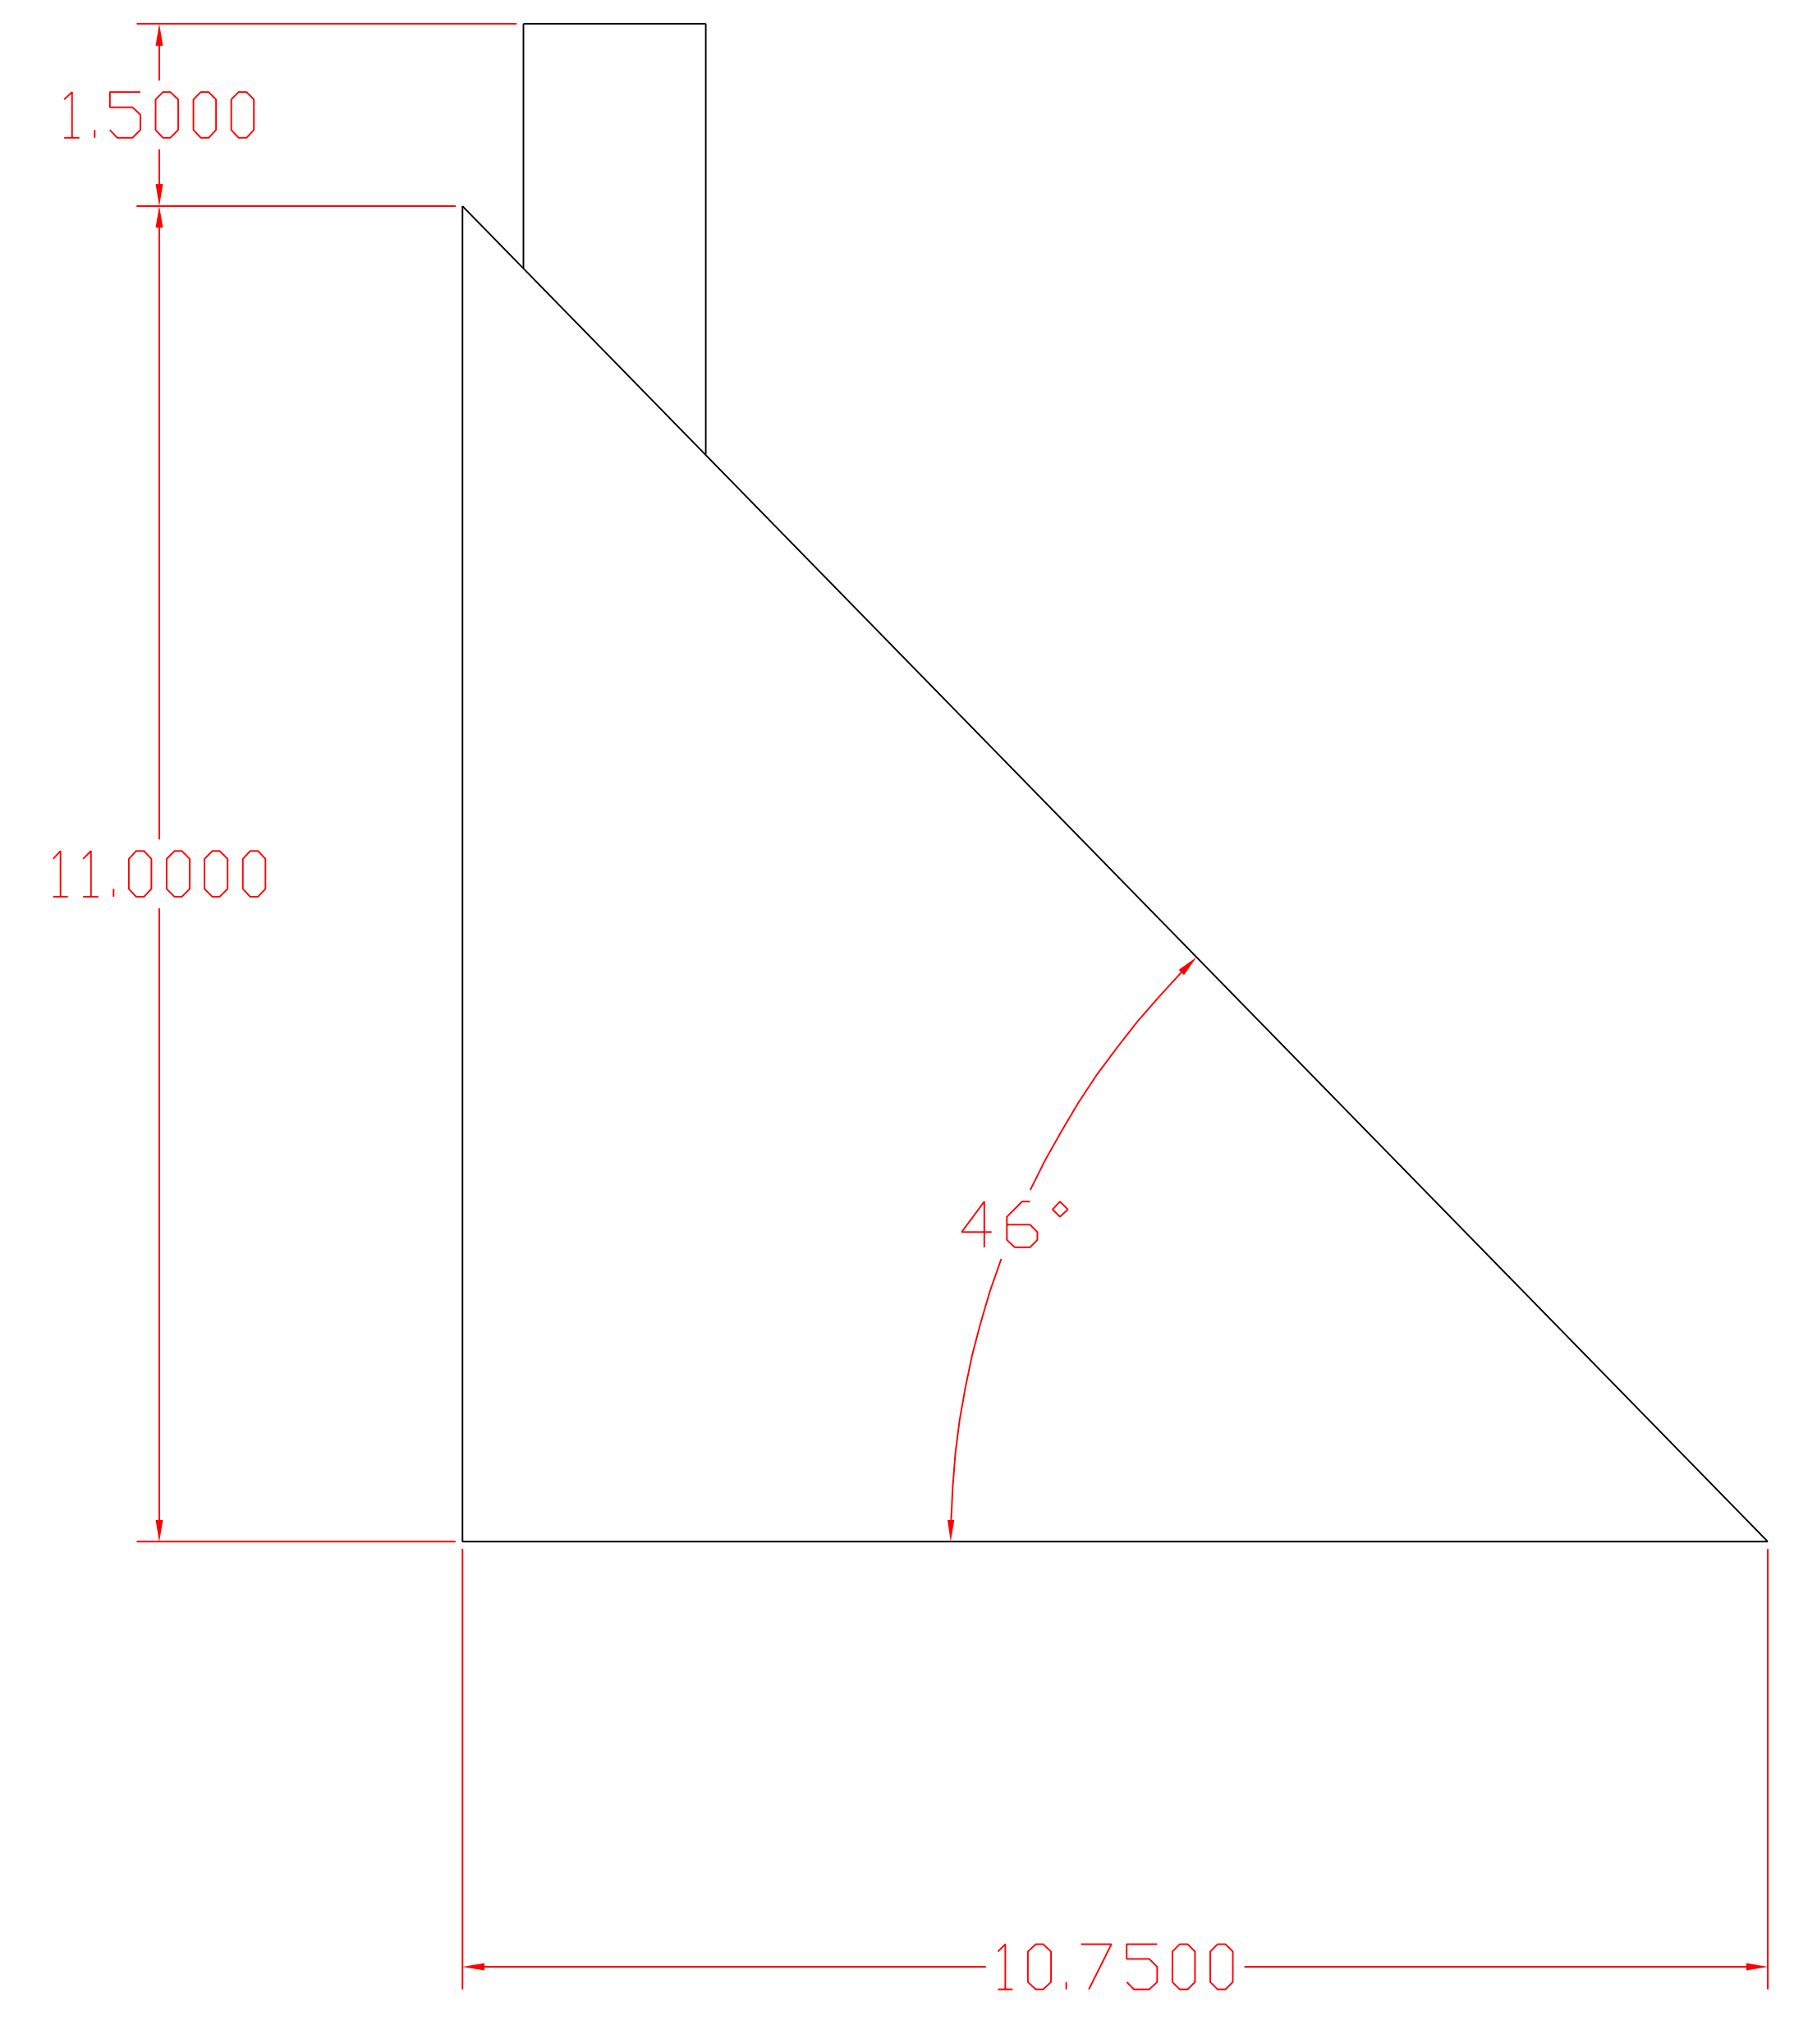

RIGHT SIDE VIEW

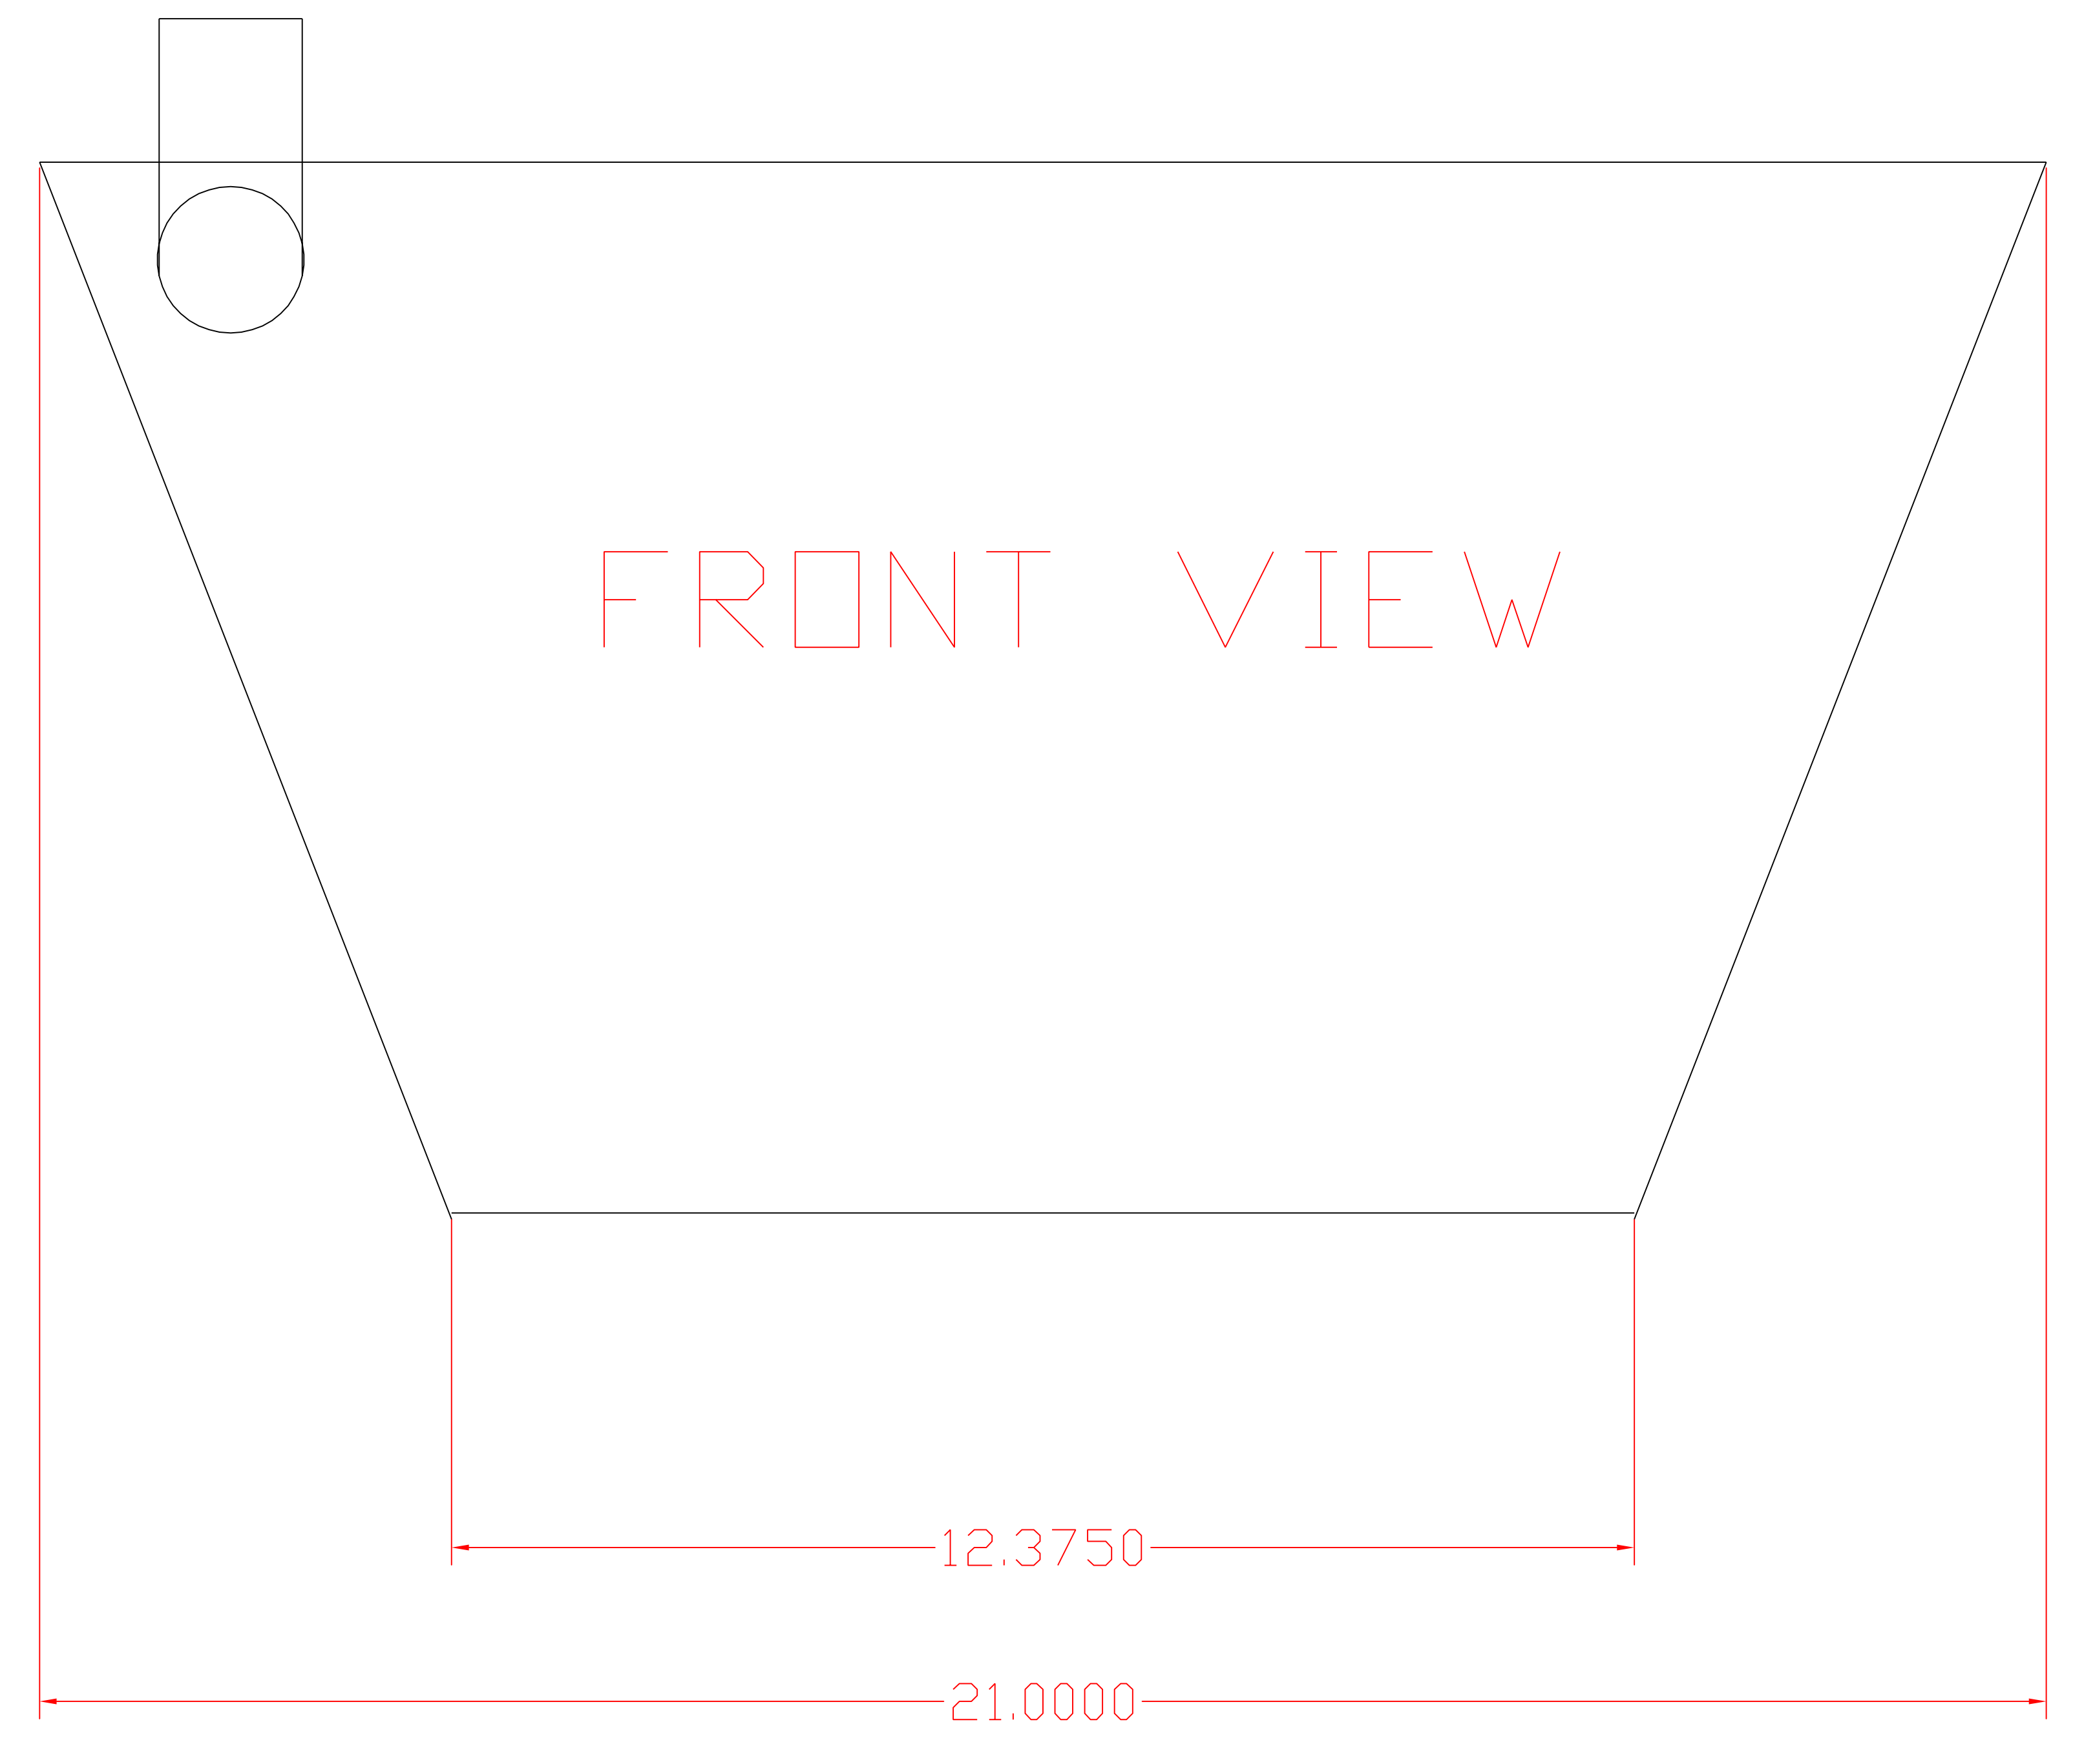

FRONT VIEW

8 7 6 5 4 3 2 1

FUEL TANK		61/FF/108	
SIZE	FIG. NO.	DWG. NO.	REV.
SCALE 3/4		LFRR-0002	0
SHEET		SHEET	